


NOTICE: WHEN GOVERNMENT DRAWINGS, SPECIFICATIONS, OR OTHER DATA ARE USED FOR ANY PURPOSE OTHER THAN IN CONNECTION WITH A SPECIFICALLY RELATED GOVERNMENT PROCUREMENT OPERATION, THE UNITED STATES GOVERNMENT THEREBY MAKES NO REPRESENTATION NOR ANY WARRANTY WHATSOEVER, AND THE FACT THAT THE GOVERNMENT MAY HAVE FORMULATED, PROVIDED, OR IN ANY WAY SUPPLIED THE SAID DRAWINGS, SPECIFICATIONS, OR OTHER DATA IS NOT TO BE REGARDED BY IMPLICATION OR OTHERWISE AS IN ANY MANNER LICENSES THE HOLDER OR ANY OTHER PERSON OR CORPORATION, OR CONVEYS ANY RIGHTS OR PERMISSION TO MANUFACTURE, USE, OR SELL ANY PATENTED INVENTION THAT MAY IN ANY WAY BE RELATED THERETO.

THIS DOCUMENT HAS BEEN PURCHASED BY THE GOVERNMENT AND MAY BE REPRODUCED AND USED IN CONNECTION WITH ANY GOVERNMENT PROCUREMENT OR BANTERMARK OPERATION.

\*FOR INFORMATION ONLY. CONTRACTOR MAY AT HIS OPTION DEVIATE FROM THESE PROCESS DETAILS.

~~\*SWE APPROVAL~~  
~~SYM PR10042-9~~

REVISIONS			
SYM	DESCRIPTION	DATE	APPROVAL
A <sub>3</sub>	A <sub>1</sub> - NOTE 1 WAS SILK SCREENING ETC.; A <sub>2</sub> -REMOVED NOTE 2 & INCORPORATED IN TO NOTE 1. A <sub>3</sub> -REMOVED SILK SCREENING NOTATION.	4 NOV. 59	42428-PC-59-A1-51 REV'D. PME

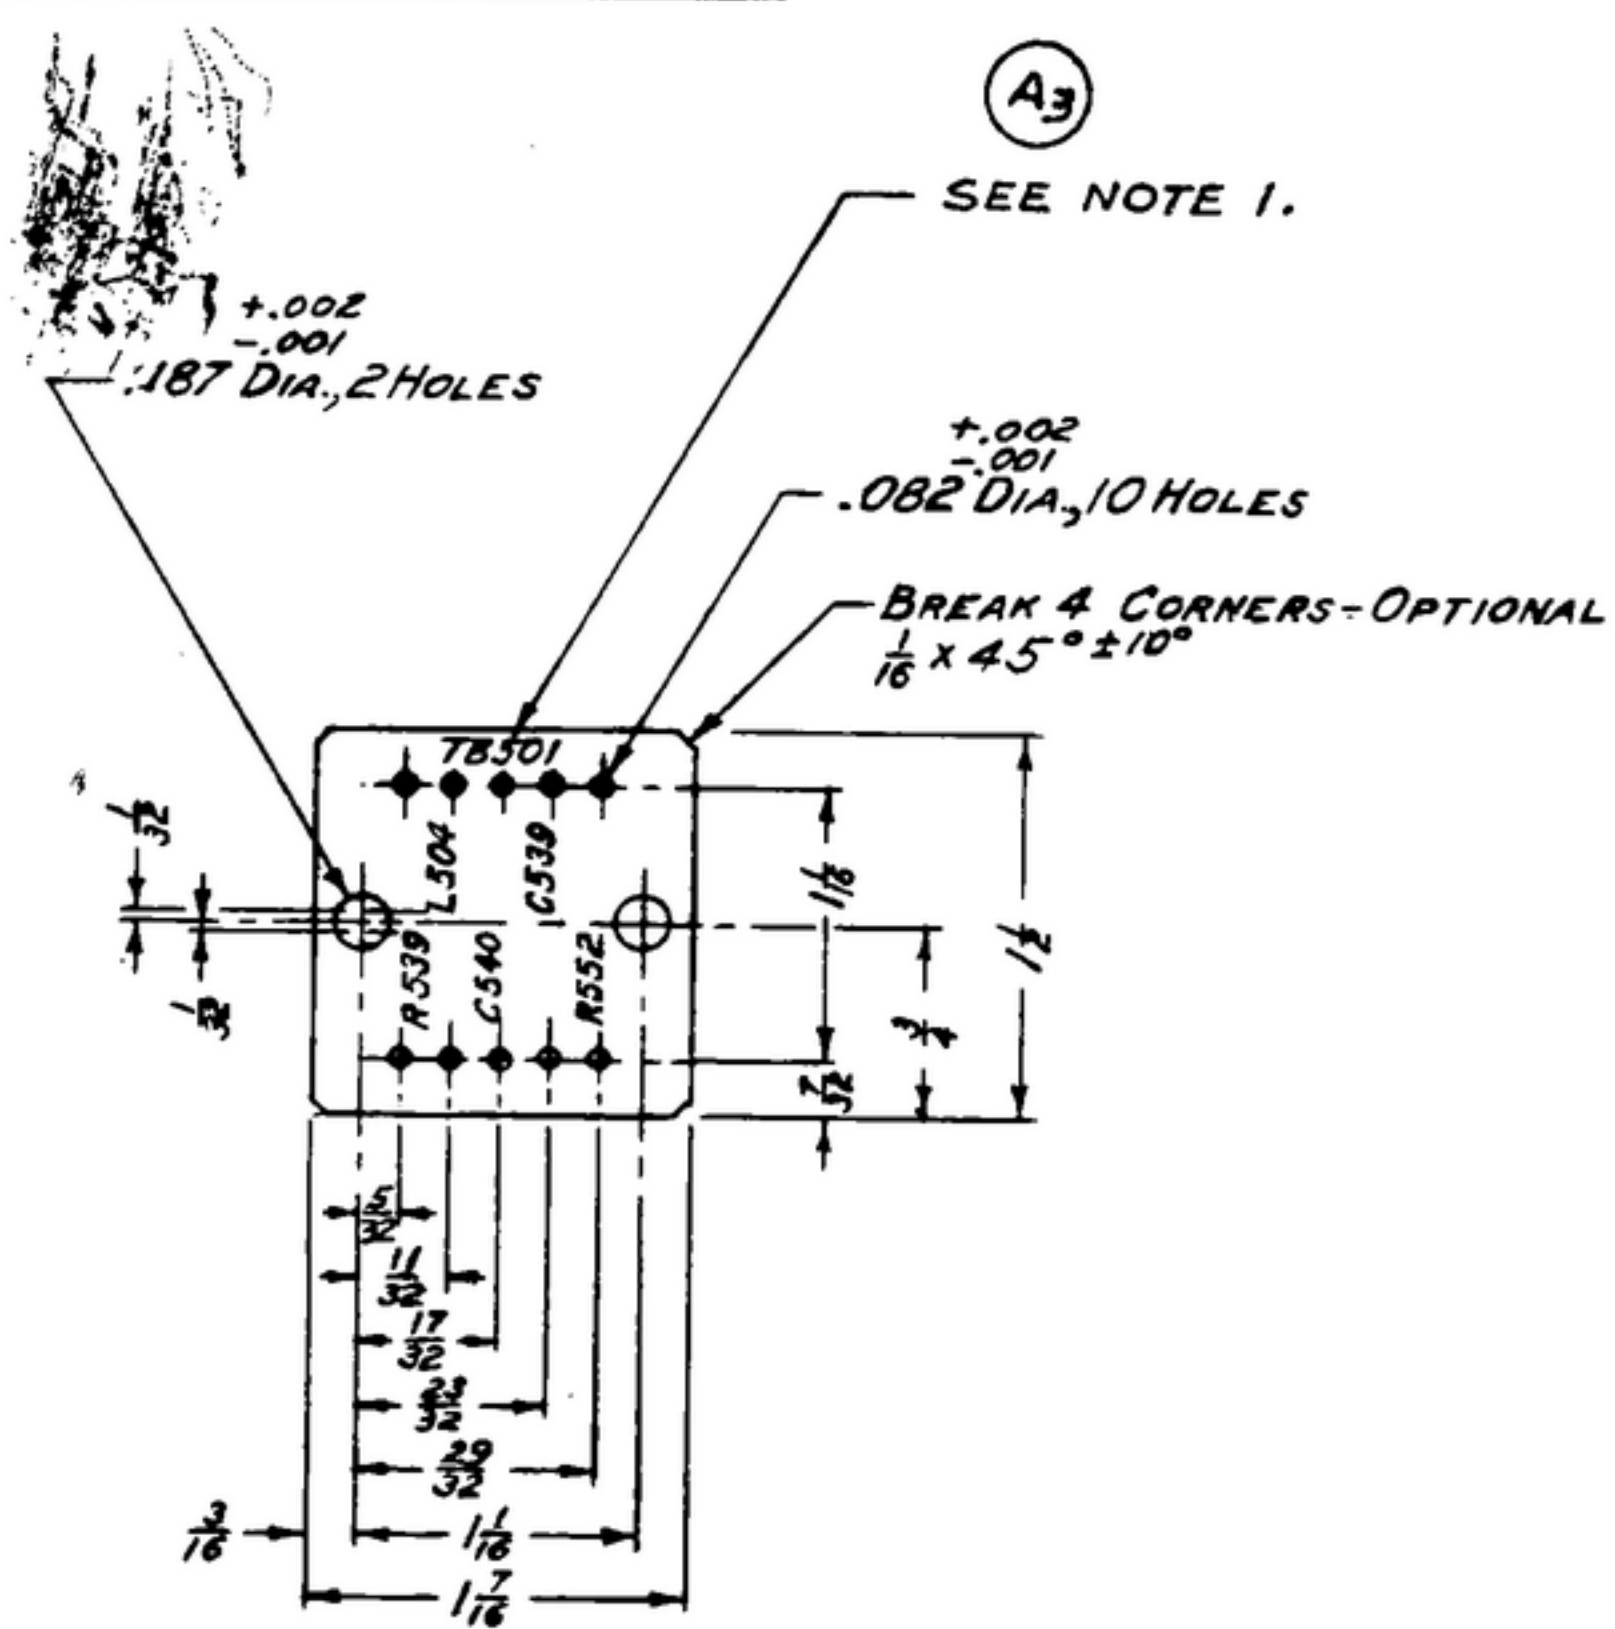

PLASTIC, TYPE PBE-P, PER SPEC MIL-P-3115, .094THK.

NOTES:

- (A<sub>1</sub>) 1. ALL CHARACTERS TO BE 3/32 HIGH GOTHIC TYPE PER SPEC. MIL-M-13231 GROUP II. COLOR TO BE WHITE, COLOR CHIP NO. 27786 PER FED STD. 595, MARKING TO BE CENTRALLY LOCATED ± 1/32, UNLESS OTHER SHOWN. COVER DESIGNATIONS WITH ONE COAT OF VARNISH PER MIL-V-173 TYPE II.
- (A<sub>2</sub>)

558-0017-002 - REF SM-B-248794 SILK SCREEN BOARD

COLLINS PART NO.	ITEM	REQD	PART NO.	DESCRIPTION	MATL	MATL SPEC
LIST OF MATERIAL						
COLLINS PART NO. <u>558-0349-002</u>						

COLLINS NO.	QTY	NEXT ASSY	USED ON
<u>558-0349-002</u>	<u>1</u>	<u>SM-B-249000</u>	<u>SG-DL-248775</u>

DRAWN JENNETT CHECKED Rln APPROVED \_\_\_\_\_

UNLESS OTHERWISE SPECIFIED:  
 DECIMAL DIMENSIONS INCLUDING HOLE SIZES MAY VARY ±.008  
 FRACTIONAL DIMENSIONS INCLUDING HOLE SIZES MAY VARY ±1/64  
 MACHINED ANGLES MAY VARY ±1°  
 SHEARED ANGLES MAY VARY ±.25°  
 BROKEN ANGLES MAY VARY ±1°  
 ECCENTRICITY BETWEEN ANY DIAMETERS ON THE SAME CENTERLINE SHALL NOT EXCEED .010 TOTAL INDICATOR READING.  
 ALL DIMENSIONS ARE FINISH DIMENSIONS INCLUDING APPLIED FINISH AND ARE GIVEN IN INCHES.

COLLINS RADIO CO.  
CEDAR RAPIDS, IOWA  
14214 PH  
51-93  
SIGNAL CORPS  
REVIEWED PME  
APPROVED HLV  
PME  
DATE 16 DEC 55 SCALE 1/1

BOARD-TERMINAL

DEPARTMENT OF THE ARMY  
SIGNAL CORPS ENGINEERING  
LABORATORIES  
FORT MONMOUTH NEW JERSEY  
SM-B-248999