~~246 0662AA~~ C-391

NOTICE: WHEN GOVERNMENT DRAWINGS, SPECIFICATIONS, OR OTHER DATA ARE USED FOR ANY PURPOSE OTHER THAN IN CONNECTION WITH A DEFINITELY RELATED GOVERNMENT PROCUREMENT OPERATION, THE UNITED STATES GOVERNMENT THEREBY INCURS NO RESPONSIBILITY NOR ANY OBLIGATION WHATSOEVER; AND THE FACT THAT THE GOVERNMENT MAY HAVE FORMULATED, FURNISHED, OR IN ANY WAY SUPPLIED THE SAID DRAWINGS, SPECIFICATIONS, OR OTHER DATA IS NOT TO BE REGARDED BY IMPLICATION OR OTHERWISE AS IN ANY MANNER LICENSING THE HOLDER OR ANY OTHER PERSON OR CORPORATION, OR CONVEYING ANY RIGHTS OR PERMISSION TO MANUFACTURE, USE, OR SELL ANY PATENTED INVENTION THAT MAY IN ANY WAY BE RELATED THERETO.

NOTE:

*FOR INFORMATION ONLY, CONTRACTOR MAY AT HIS OPTION DEVIATE FROM THESE PROCESS DETAILS

~~*SWE APPROVAL~~
~~SYM PR10042-G~~

REVISIONS			
SYM	DESCRIPTION	DATE	APPROVAL
A_2	A_1 - ADDED NOTE 2. A_2 - PART NO. WAS 81715-WE	15OCT. 59	42428-PC-59-A1-51 REV'D PME

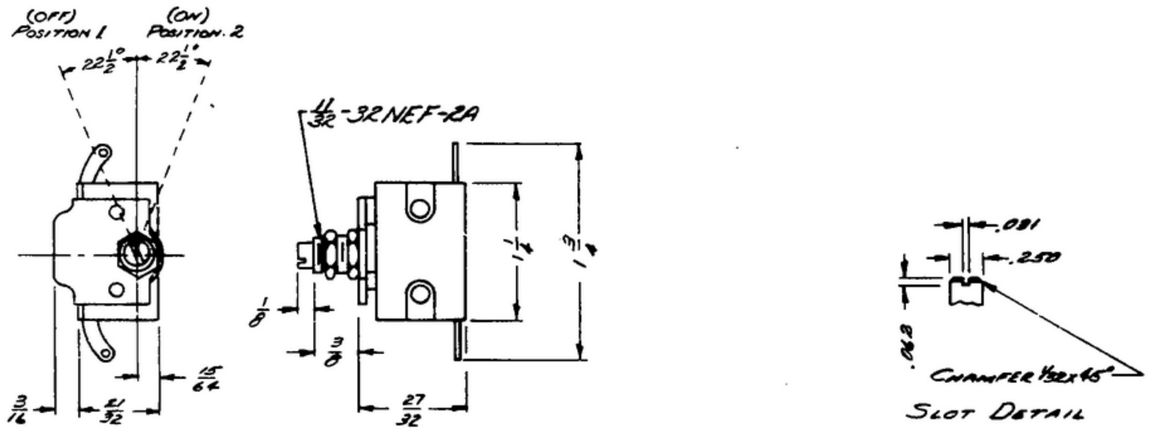

SLOT DETAIL

(A2) 1- SWITCH SHALL BE #81715-WF AS SUPPLIED BY ARROW-HART & HEGEMAN, HARTFORD, CONNECTICUT, OR EQUAL.

(A1) 2.- CONTACT RATING 3A AT 250V. RESISTIVE LOAD.

LIST OF MATERIAL

ITEM	PART NO.	DESCRIPTION	MATL.	MATL. SPEC.	

SM-D-343623		
SM-D-249135	SC-DL-248775	
~~SM-D-178477~~	~~SC-DL-178467~~	
NEXT ASSY	USED ON	
APPLICATION		

UNLESS OTHERWISE SPECIFIED
DIMENSIONS ARE IN INCHES
TOLERANCES ON FRACTIONS ±1/64 DECIMALS ±.005 ANGLES —

AUTHENTICATION
DRAWN 21 SEPT 55 - PH-30-9-5
TRACED PHOTO
CHECKED
VERIFIED PD GR
APPROVED PD GR
REVIEWED PME
DATE 1 SEPT 55

SWITCH

SCALE — —

SIGNAL CORPS ENGINEERING LABORATORIES
FORT MONMOUTH NEW JERSEY

SM-B-178480

PD-794—676-2871-60—ASST—177438

WHEN REFERRING TO THIS DRAWING STATE DRAWING NO., APPLICABLE ISSUE SYMBOL, IF ANY, AND DATE