RH. 0.5

R-391 ~~506-1792-0C~~

SUCH OTHER GOVERNMENT DRAWINGS, SPECIFICATIONS, OR OTHER DATA ARE USED FOR ANY PURPOSE OTHER THAN IN CONNECTION WITH A DEFINITELY RELATED GOVERNMENT PROCUREMENT OPERATION, THE UNITED STATES GOVERNMENT THEREBY INCURS NO RESPONSIBILITY NOR ANY OBLIGATION WHATSOEVER; AND THE FACT THAT THE GOVERNMENT MAY HAVE FORMULATED, FURNISHED, OR IN ANY WAY SUPPLIED THE SAID DRAWINGS, SPECIFICATIONS, OR OTHER DATA IS NOT TO BE REGARDED BY IMPLICATION OR OTHERWISE AS IN ANY MANNER LICENSING THE HOLDER OR ANY OTHER PERSON OR CORPORATION, OR CONVEYING ANY RIGHTS OR PERMISSION TO MANUFACTURE, USE, OR SELL ANY PATENTED INVENTION THAT MAY IN ANY WAY BE RELATED THERETO.

NOTE:

*FOR INFORMATION ONLY, CONTRACTOR MAY AT HIS OPTION DEVIATE FROM THESE PROCESS DETAILS

~~* SWE APPROVAL~~
~~SYM PR 10042-3~~

REVISIONS			
SYM	DESCRIPTION	DATE	APPROVAL
A_3	A_1 - RENUMBERED NOTES; A_2 - ADDED APPL. SM-B-178959, SC-DL-248775. A_3 - COMP. 302 WAS COMP. G.	6 OCT. 59	4242B-PC-59-A1-51 REV'D. PME

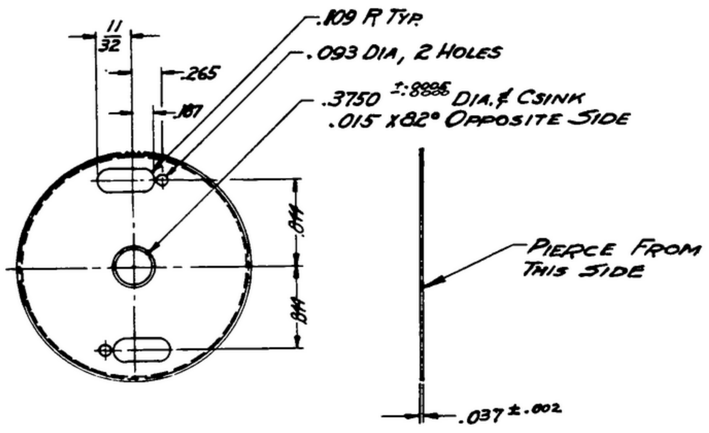

NOTES: (A_3)

(A_1) 1.- STEEL, COMP 302 COND ANNEALED, PER SPEC MIL-S-5059.

2.- GEAR DATA:
NORMAL DIAMETRAL PITCH ——— 48
NORMAL PRESSURE ANGLE ——— 14 ½°
NUMBER OF TEETH ——— 108
THEORETICAL PITCH DIAMETER ——— 2.250
BACKLASH .0015 TO .0025 WHEN REFERRED TO THE THEORETICAL PITCH CIRCLE
AMERICAN STANDARD INVOLUTE TOOTH FORM
ALL TERMS USED AS DEFINED BY AGMA STANDARDS.

3.- PART MUST BE FLAT WITHIN .004 TIR.

4.- PART MUST BE FREE OF BURRS & SHARP EDGES.

5.- ECCENTRICITY BETWEEN PITCH DIAMETER & BORE. MUST NOT EXCEED .002 TIR.

6.- ALL DIMENSIONS FOR SLOTS & .093 DIA. HOLES ARE TYPICAL.

ITEM	PART NO.	DESCRIPTION	MATL	MATL SPEC	QTY

LIST OF MATERIAL

NEXT ASSY	USED ON
(A_2) SM-B-178959	SC-DL-248775
SM-B-178959	SC-DL-178967

APPLICATION

UNLESS OTHERWISE SPECIFIED
DIMENSIONS ARE IN INCHES
TOLERANCES ON
FRACTIONS ± 1/64 DECIMALS ± .005 ANGLES ———

AUTHENTICATION
DRAWN 21062-PR-10-59
TRACED PHOTO
CHECKED
VERIFIED P.D.BR.
APPROVED P.D.BR.
REVIEWED PME
DATE 15-MAR-54

GEAR

SCALE 1/1

SIGNAL CORPS ENGINEERING LABORATORIES
FORT MONMOUTH NEW JERSEY

SM-C-178960

WHEN REFERRING TO THIS DRAWING STATE DRAWING NO., APPLICABLE ISSUE SYMBOL, IF ANY, AND DATE