EQUIP. TYPE R390A/URR EXP. NO.

~~Col. 540 7965 004~~

*FOR INFORMATION ONLY. CONTRACTOR MAY AT HIS OPTION DEVIATE FROM THESE PROCESS DETAILS.

* SWE APPROVAL	
SYM	PR 10042-13
B	CA84960

REVISIONS			
SYM	DESCRIPTION	DATE	APPROVAL
A_3	A_1 - ADDED ITEM 7, A_2 ADDED NEW APPLICATION, A_3 ITEM 3 DESCRIPTION WAS "CAN."	20 NOV. 59	PME
B_1	(1) ADDED NOTE 11.	10 NOV 60	PME
C_1	(1) ± 1% WAS ± .1%	26 MAR 1965	21582-PC-61 PME

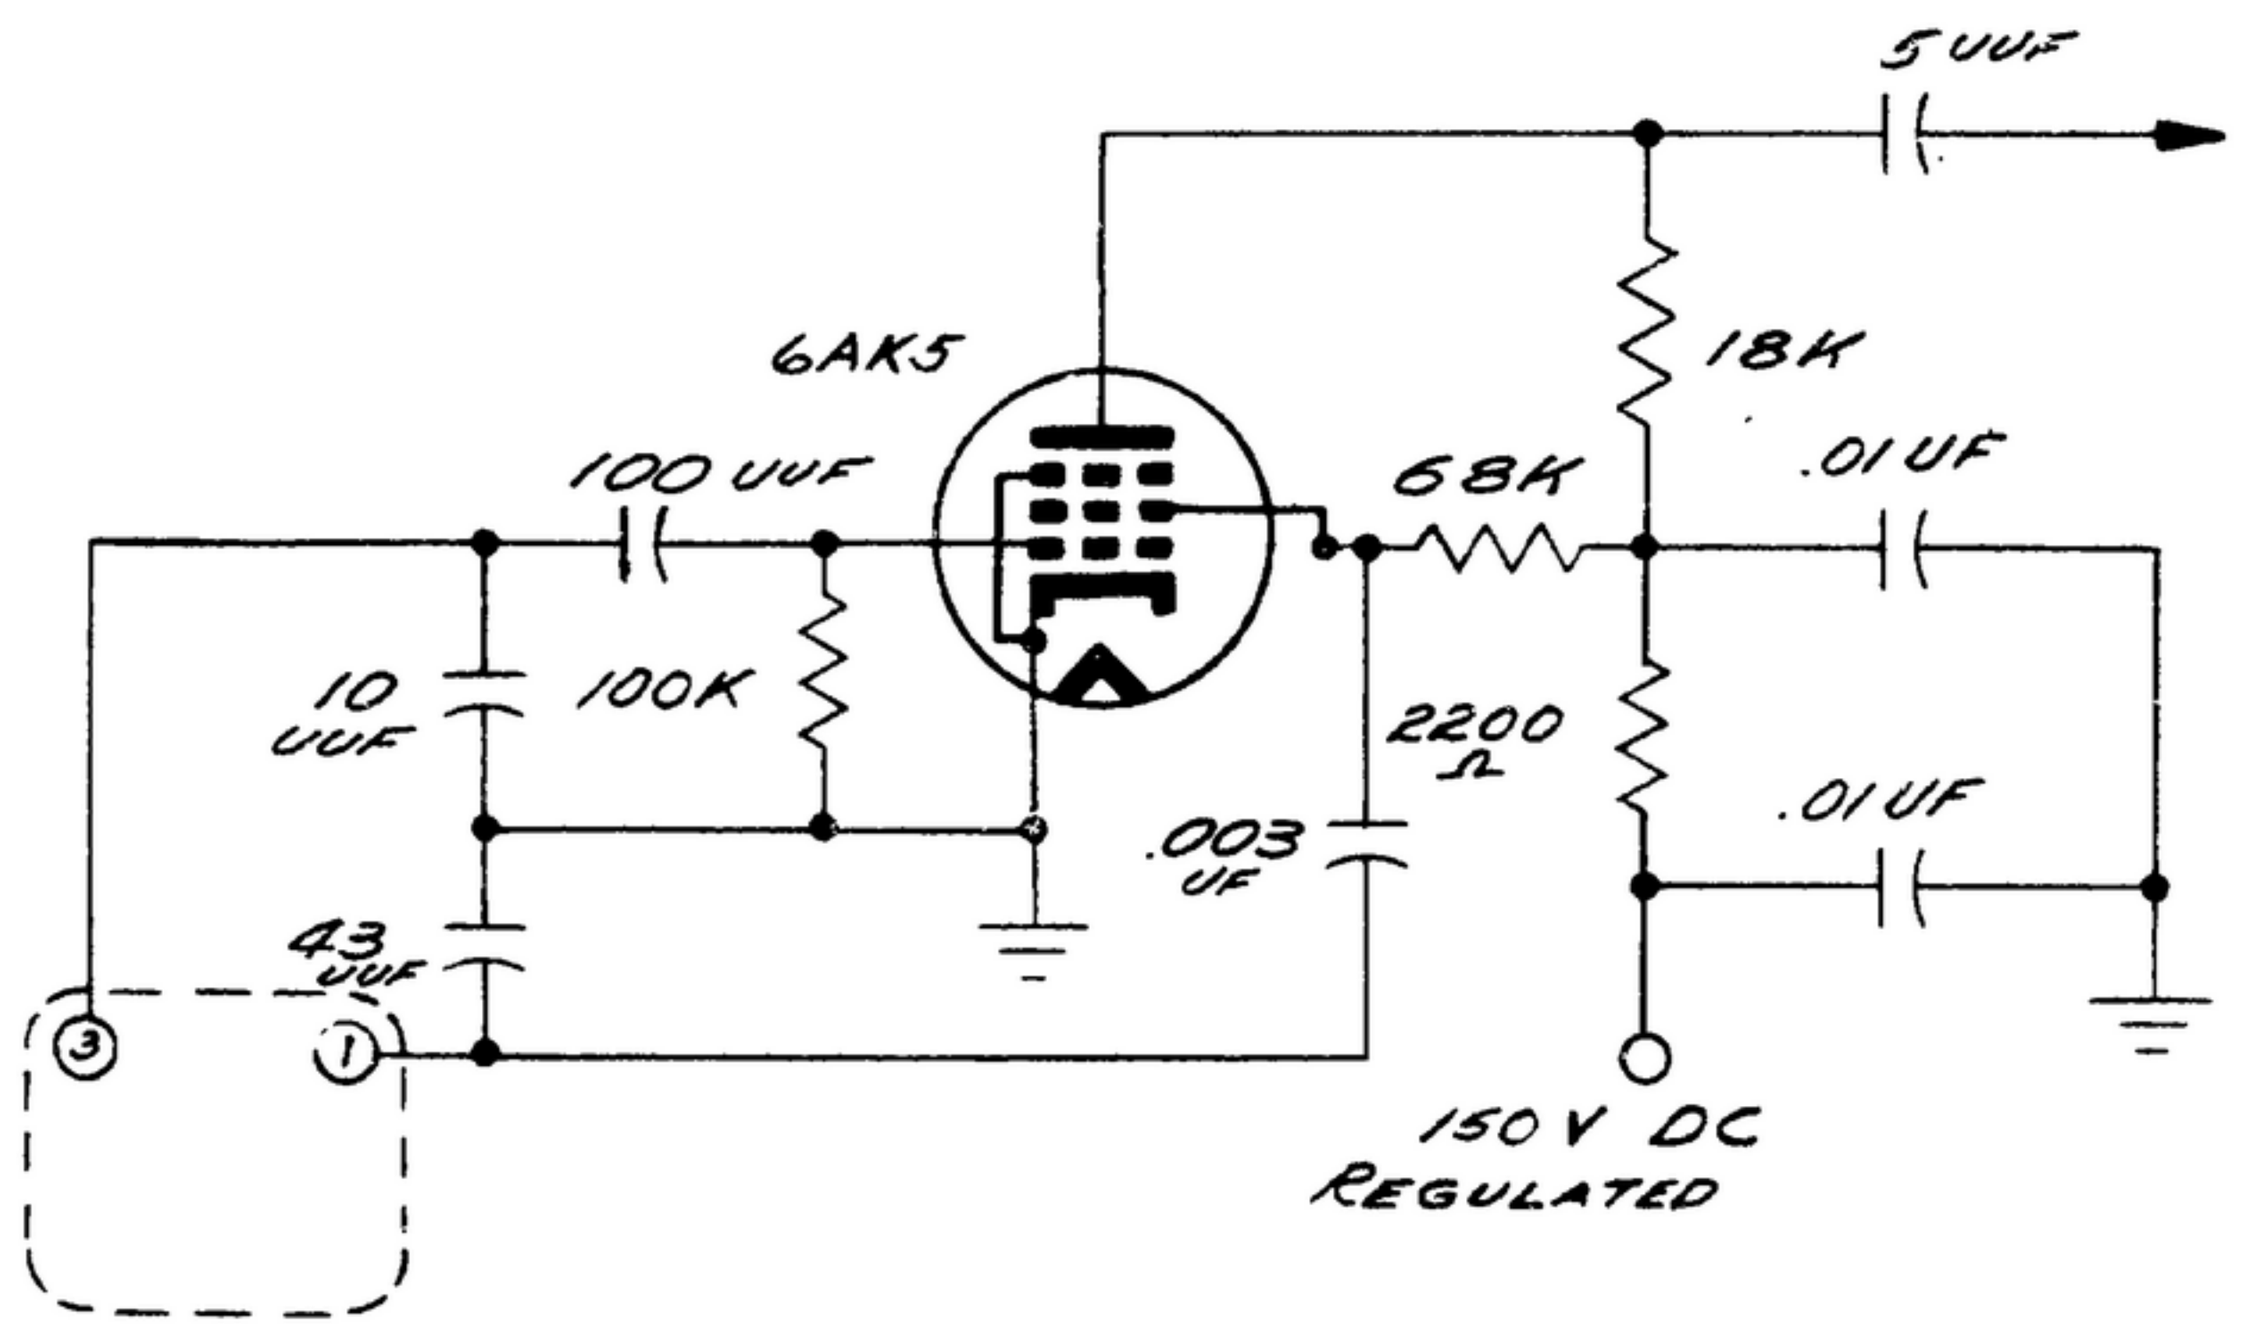

TEST OSCILLATOR

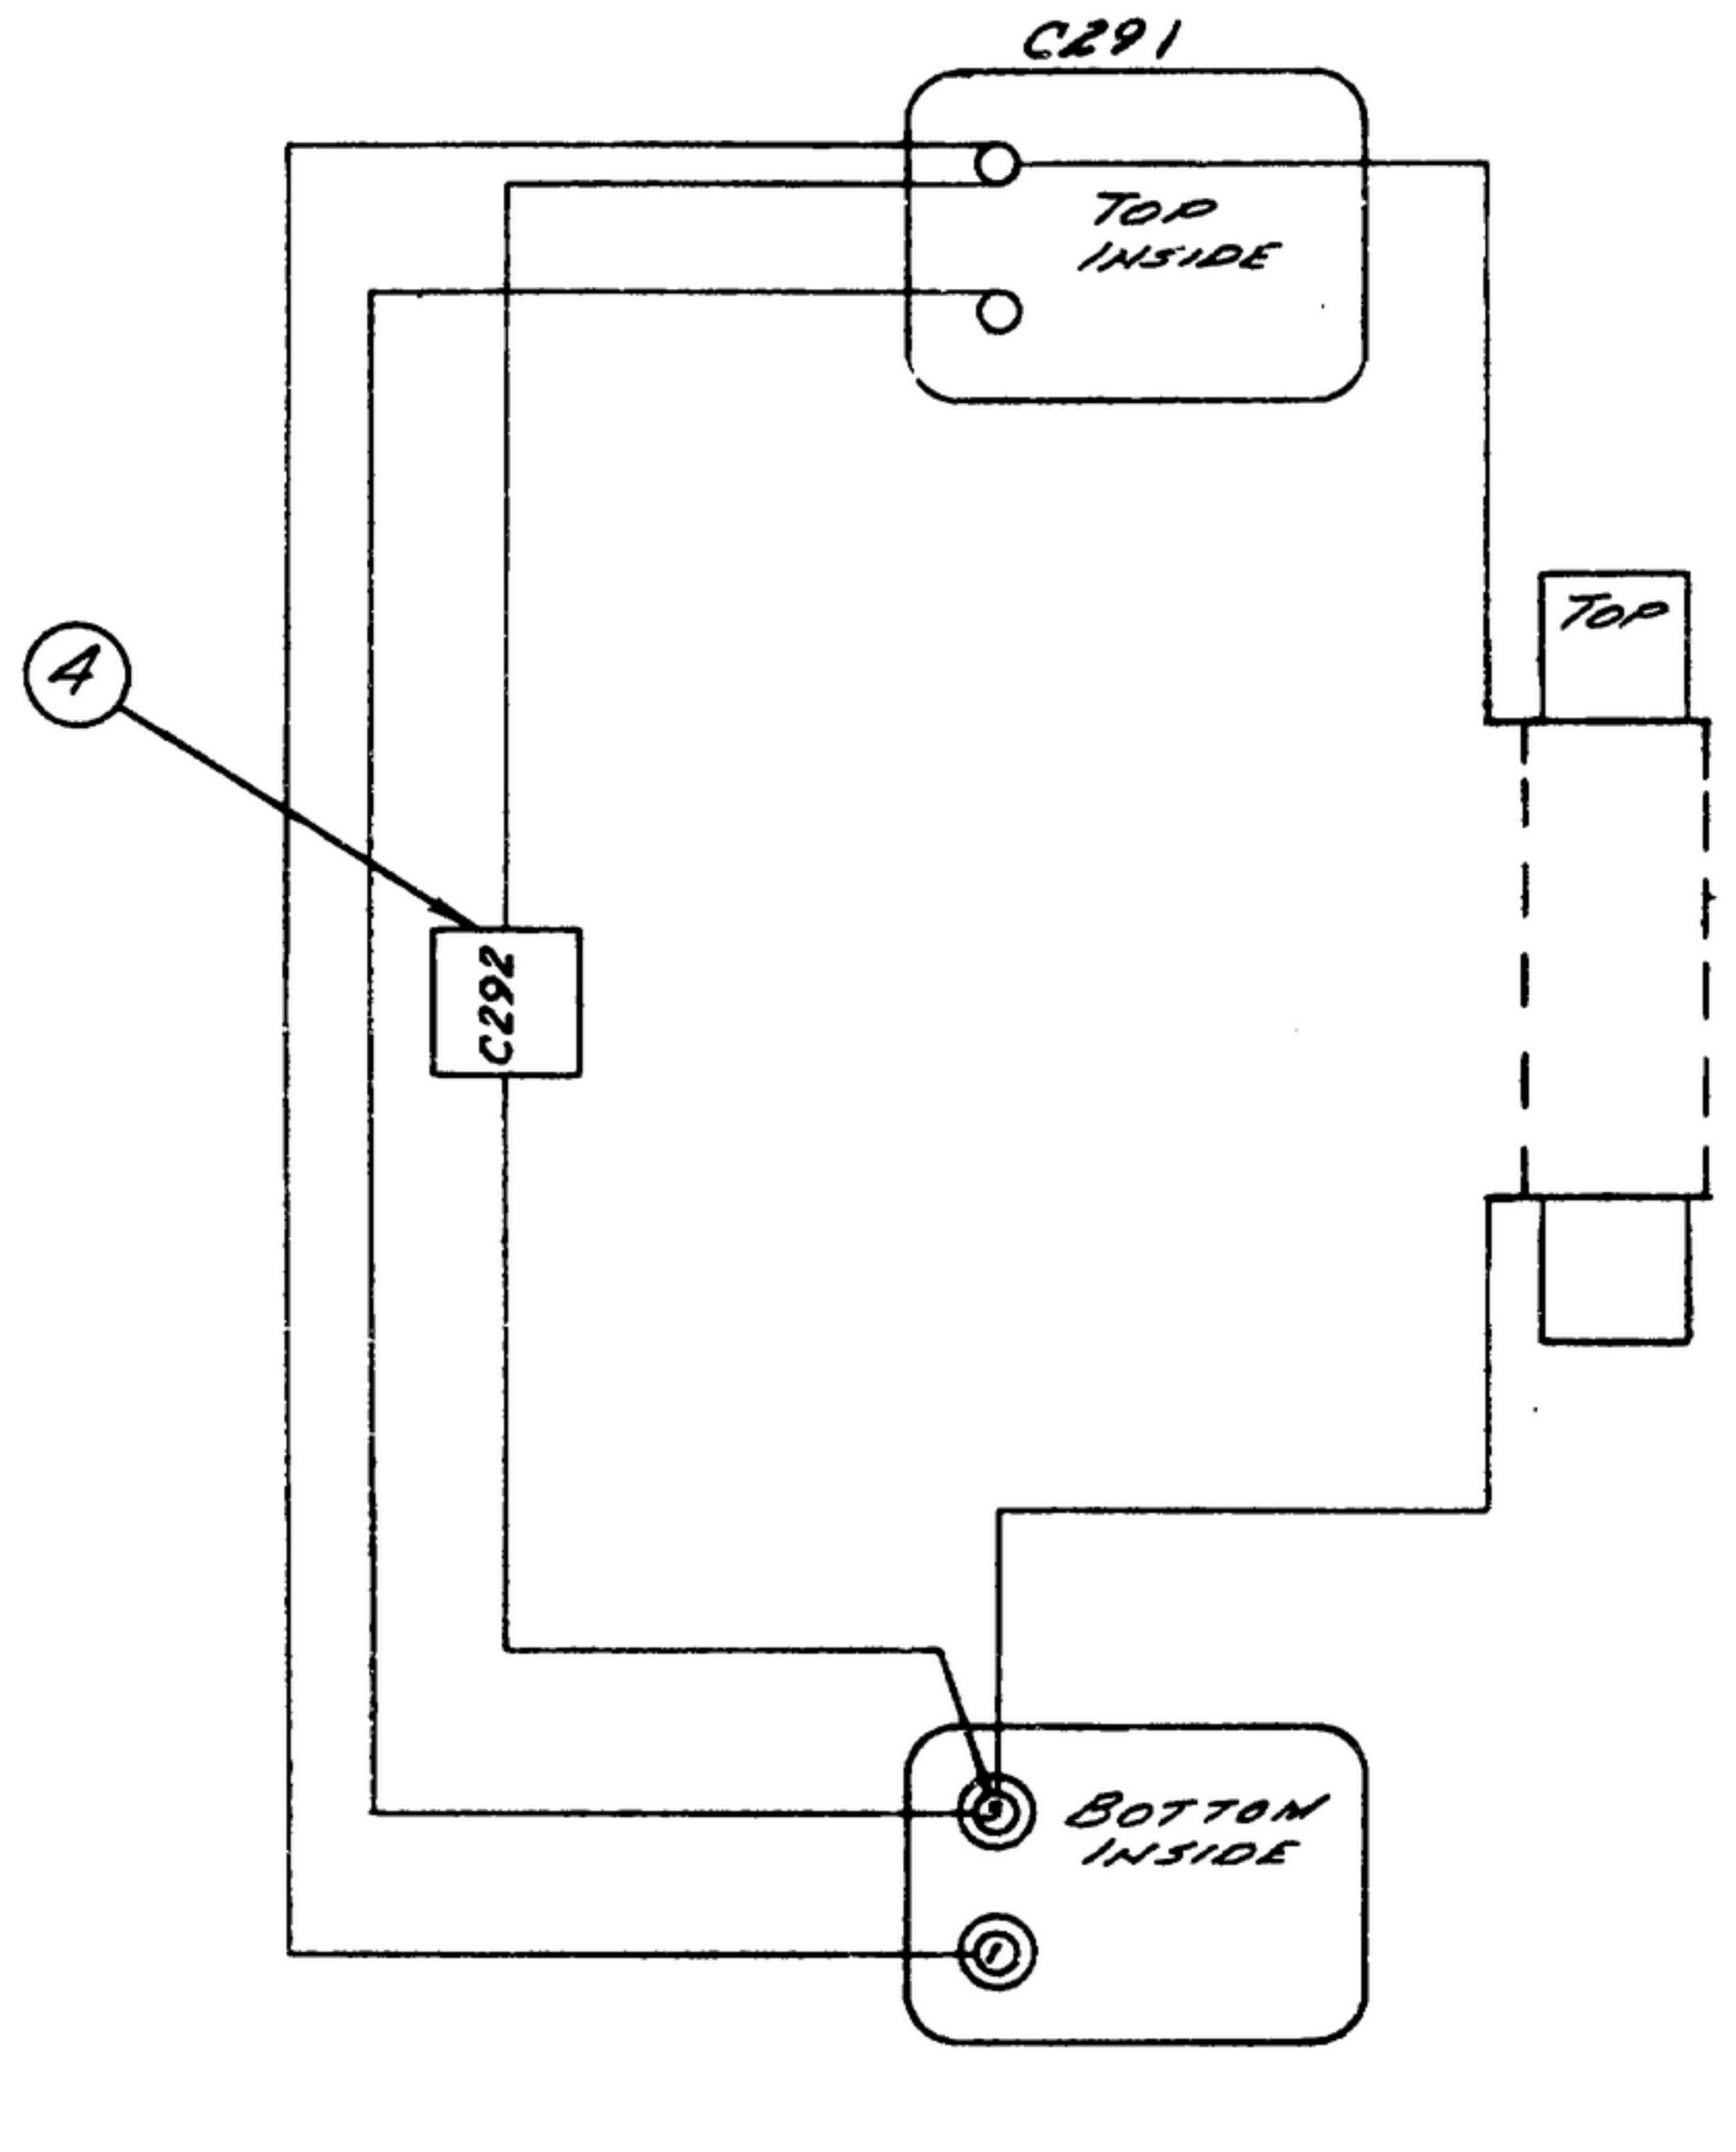

WIRING DIAGRAM

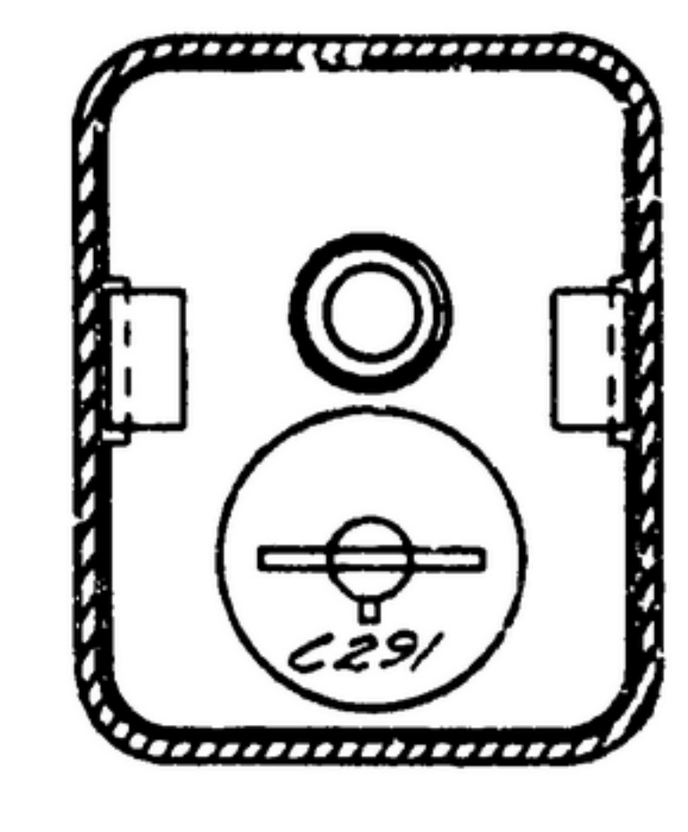

SECTION A-A

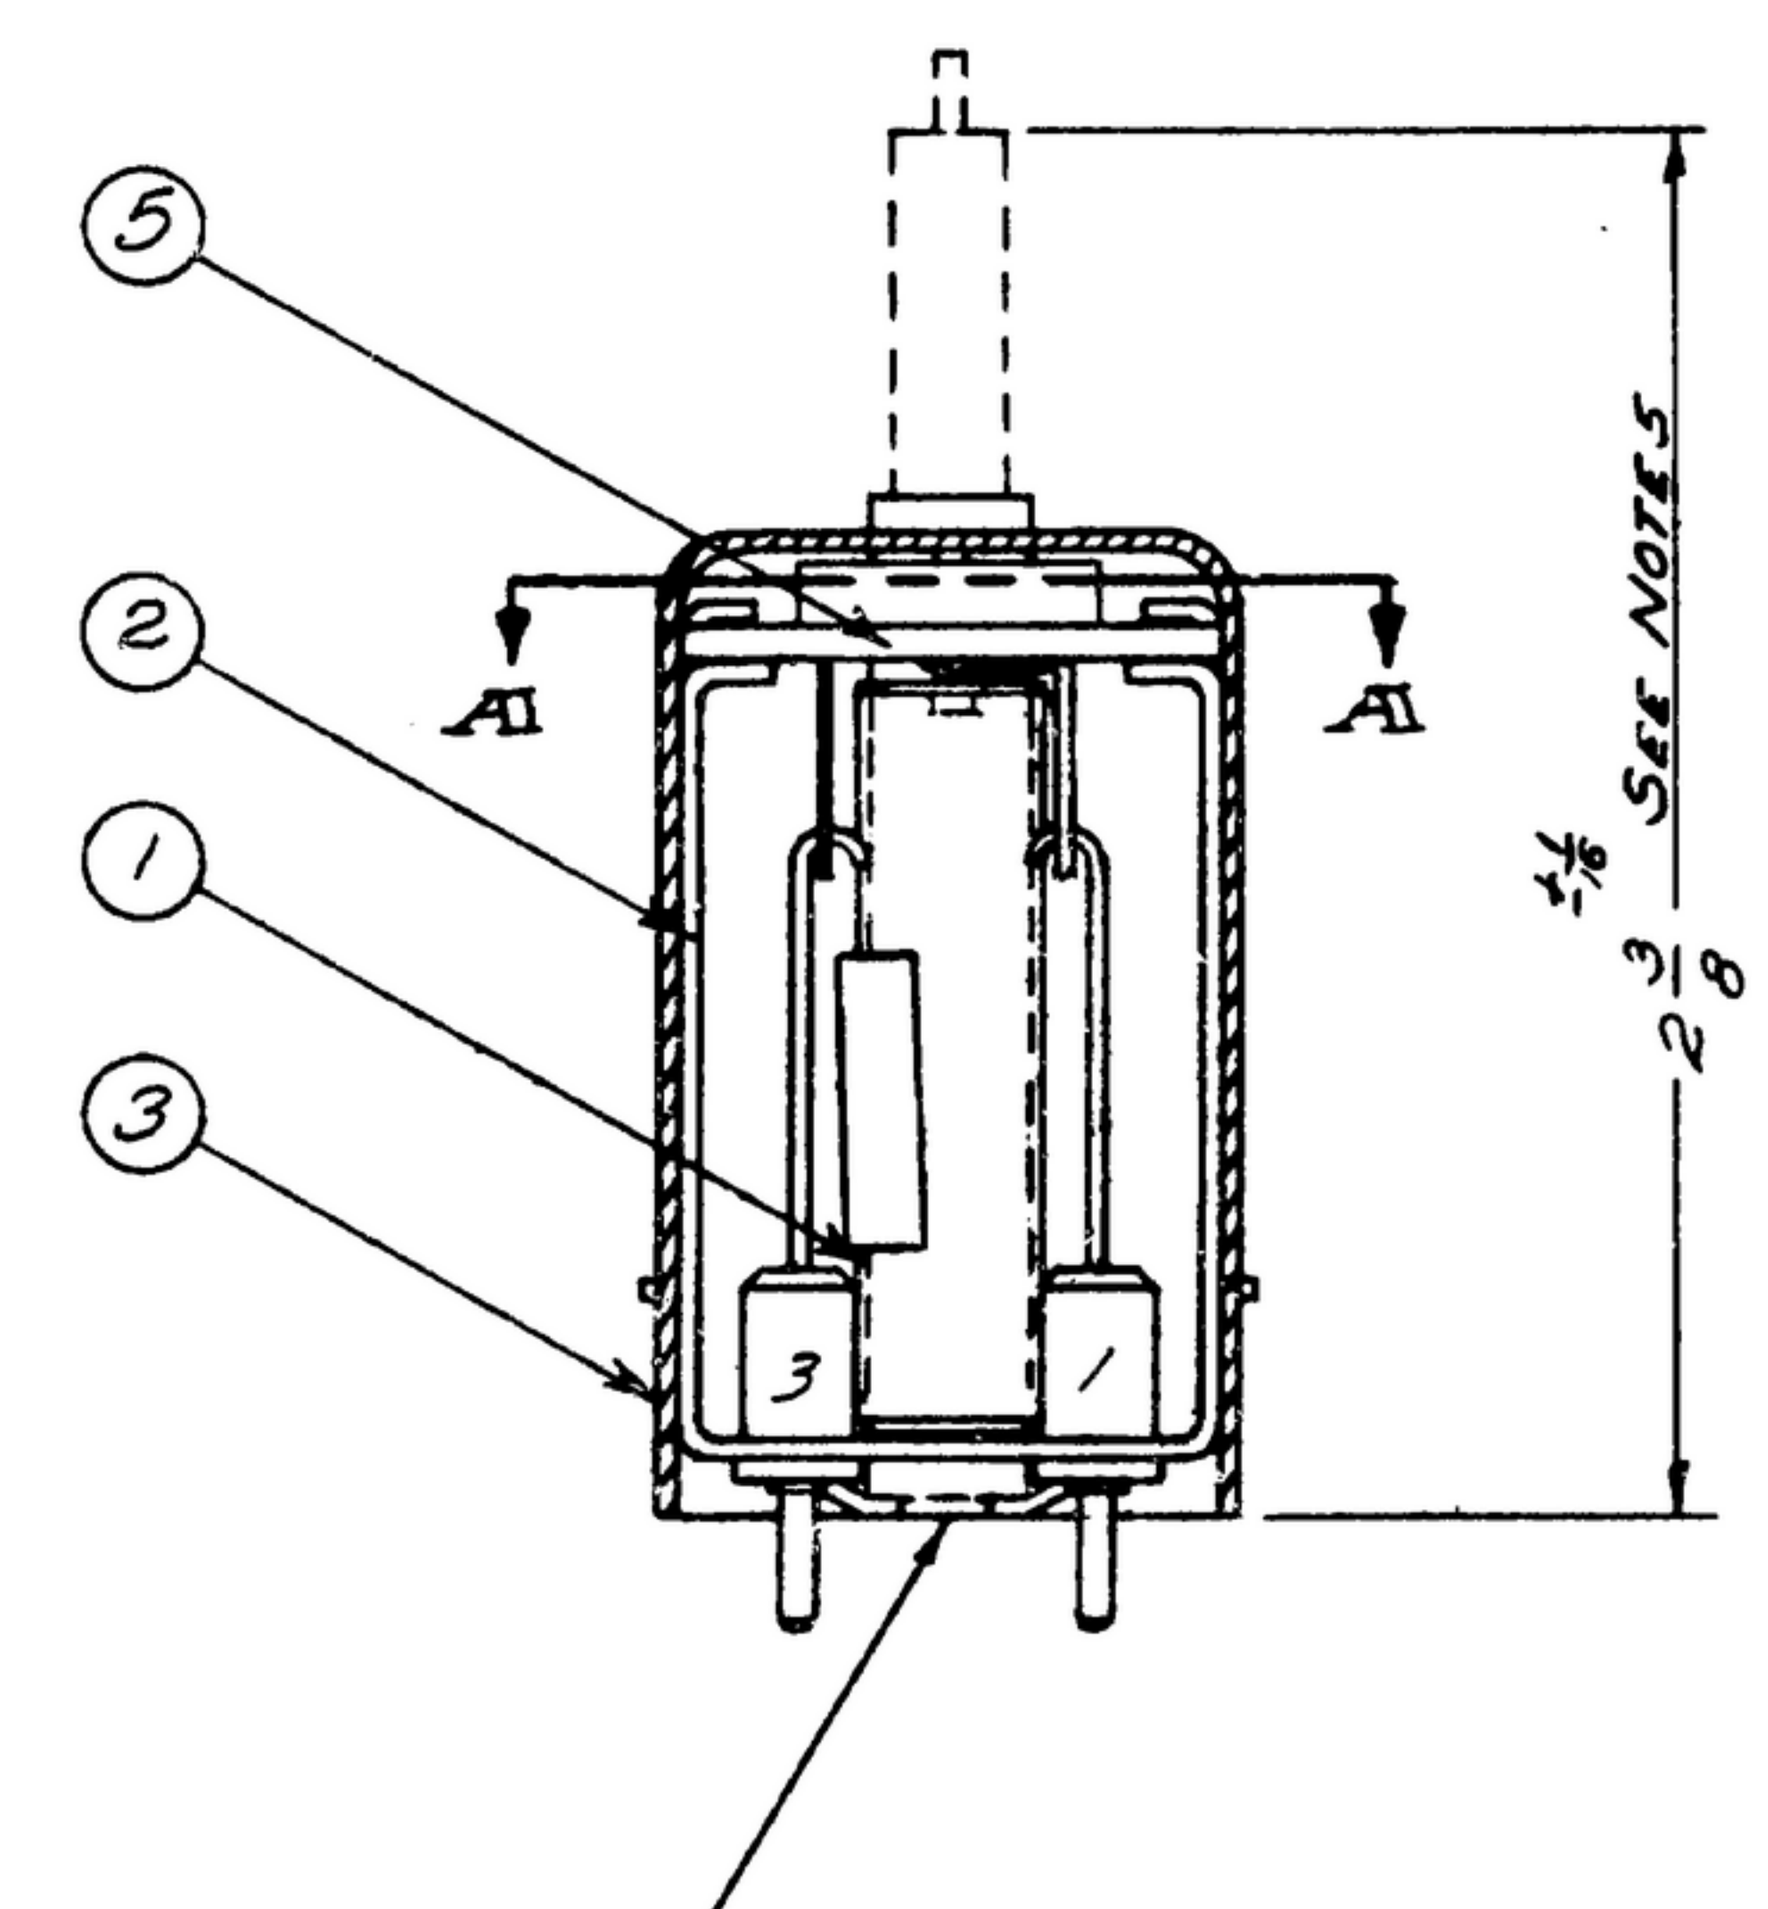

SEE NOTE 2

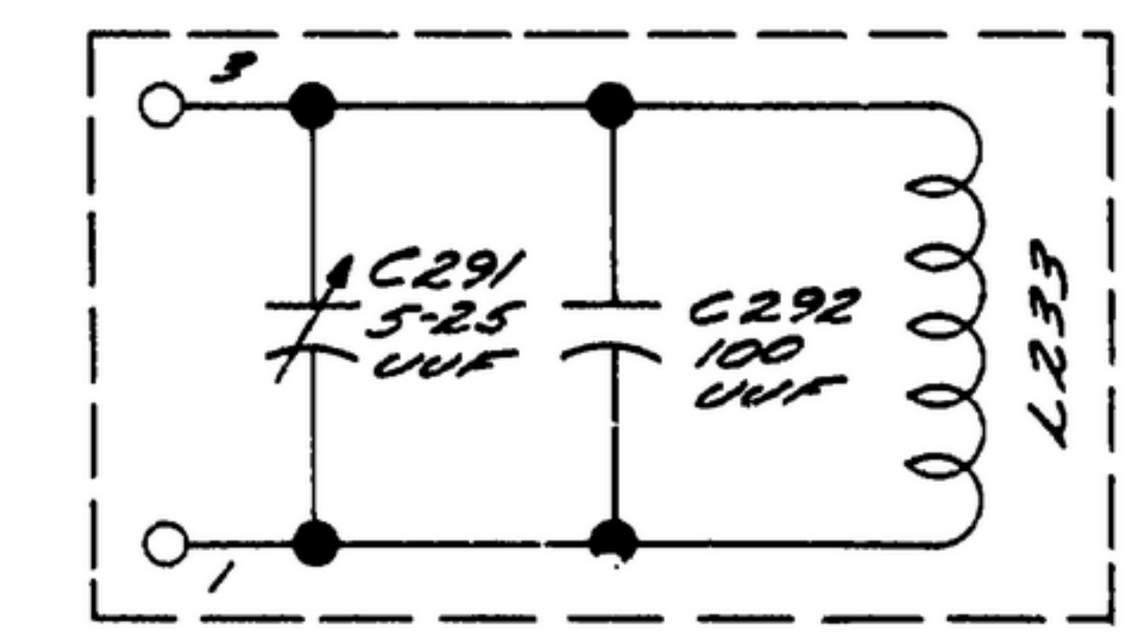

SCHEMATIC DIAGRAM OF COIL ASSY

CORE POSITION INCHES ±.0002	TEST OSC FREQ MC	FREQ TOL KC	EFFECTIVE PARALLEL RESISTANCE (OHMS) ±25%
− 0.0300	3.0375	18	
0.0000	3.00	12	25000
ǂ 0.0800	2.90	ǂ	
0.1600	2.80	12	
0.2400	2.70	12	
0.3200	2.60	12	
0.4000	2.50	12	35000
0.4800	2.40	12	
0.5600	2.30	12	
0.6400	2.20	12	
ǂ 0.7200	2.10	ǂ	
0.8000	2.00	12	45000
0.8300	1.9625	18	
ǂ ALIGNMENT POINTS SEE NOTE 4			

NOTES:

1. SOFT SOLDER PER SPEC MIL-S-6872 USING ROSIN CORE SOLDER (7), COMP. SN 60.
2. COIL FORM OF COIL ASSY (1) TO BE CONCENTRIC WITH .140 DIA HOLE IN FRAME (2) WITHIN .020 T.I.R.
3. MOUNTING POSITION OF CAPACITOR OPTIONAL, PROVIDING NO CAPACITOR COMES WITHIN 1/16 OF COIL WINDING.
4. ALIGNMENT: WITH COIL ASSY IN TEST JIG, AND STANDARD POWDERED IRON TUNING CORE POSITIONED IN THE COIL, ADJUST VARIABLE CAPACITOR (5), UNTIL TEST OSCILLATOR FREQUENCY IS WITHIN 500 CPS OF THE VALUE SHOWN IN TABLE AT TWO ALIGNMENT POINTS. THE FINAL SETTING OF THE VARIABLE CAPACITOR (5) SHALL LEAVE A RESERVE ADJUSTMENT OF 4 MMF.
5. BROKEN LINES INDICATE OUTLINE OF STANDARD POWDERED IRON TUNING CORE OF TEST JIG. DIMENSION APPLIES TO THE CORE IN 0.0800 ALIGNMENT POSITION AFTER ELECTRICAL ALIGNMENT PER NOTE 4.
6. TRACKING: TEST OSCILLATOR FREQUENCY SHALL BE WITHIN THE TOLERANCE OF TABLE AT SPECIFIED CORE INSERTIONS AT 25°C.
7. STABILITY: THE RESONANT FREQUENCY OF THE TUNING COIL SHALL VARY NO MORE THAN 40 PPM/°C FROM THE 25°C VALUE OVER THE SPECIFIED TEMPERATURE RANGE.
8. TEMPERATURE RANGE −40°C TO +85°C OPERATING, −62°C TO +85°C STORAGE.
9. THE COIL ASSY SHALL BE BONDED TO THE BASE PLATE AND TO THE VARIABLE CAPACITOR BOARD TOP (5) WITH BONDING AGENT (6) #R-313 AS SUPPLIED BY CARL H. BIGGS CO, LOS ANGELES CALIF, OR EQUAL.
10. HUMIDITY: UNIT SHALL BE CAPABLE OF OPERATION AFTER EXPOSURE TO 5 HUMIDITY CYCLES CONDUCTED IN ACCORDANCE WITH THE LATEST VERSION OF SIGNAL CORPS DRAWING SC-DL-16286. UPON COMPLETION OF THE HUMIDITY CYCLES THE UNIT SHALL BE ALLOWED TO DRY AT 25°C AMBIENT FOR A PERIOD OF 1 HOUR.
11. (B_1) TUNING CORE REFERRED TO IN NOTE 5 SHOULD BE SM-C-249244 AND MUST BE WITHIN ± 1% OF NOMINAL PERMEABILITY. (C_1)

LIST OF MATERIAL

* SWE PART NO.	ITEM	REQD	PART NO.	DESCRIPTION	MATL	MATL SPEC	NOTES
(A_1) 10S130317-7	7	AS REQ'D		SOLDER, SOFT		QQ-S-571	1
11S130318-7	6	AS REQ'D		BONDING AGENT			9
	5	1	SM-C-283230-2	CAPACITOR-VARIABLE			9
	4	1	SM-C-283226-16	CAPACITOR-FIXED			
(A_3)	3	1	SM-B-249169	CAN, MARKED			
	2	1	SM-B-249061	FRAME ASSY			9
	1	1	SM-B-283281	COIL ASSY			9

~~COLLINS PART NO. 558 0449 004~~ (S)

~~COLLINS NO.~~	~~QTY~~	NEXT ASSY	USED ON
		SM-D-343629	↑
(A_2) ~~558 0453 004~~	~~3~~	SM-D-248854	SC-DL-248775

APPLICATION

DRAWN: NUGEN | CHECKED: [signature] | APPROVED:

UNLESS OTHERWISE SPECIFIED:
DECIMAL DIMENSIONS INCLUDING HOLE SIZES MAY VARY ±.005
FRACTIONAL DIMENSIONS INCLUDING HOLE SIZES MAY VARY ±1/64
MACHINED ANGLES MAY VARY ±.1°
SHEARED ANGLES MAY VARY ±.25°
BROKEN ANGLES MAY VARY ±1.°
ECCENTRICITY BETWEEN ANY DIAMETERS ON THE SAME CENTERLINE SHALL NOT EXCEED .010 TOTAL INDICATOR READING.
ALL DIMENSIONS ARE FINISH DIMENSIONS INCLUDING APPLIED FINISH AND ARE GIVEN IN INCHES.

~~COLLINS RADIO CO. CEDAR RAPIDS, IOWA~~
14214-PH-51-93

SIGNAL CORPS
REVIEWED PME
APPROVED HLY PME
DATE 22 FEB 56 | SCALE 2/1

COIL ASSY - I.F

DEPARTMENT OF THE ARMY
SIGNAL CORPS ENGINEERING LABORATORIES
FORT MONMOUTH NEW JERSEY

SM-D-249 098

WHEN REFERRING TO THIS DRAWING STATE DRAWING NO., APPLICABLE ISSUE SYMBOL, IF ANY, AND DATE